


ITEM	QTY	MFG	CATALOG	DESCRIPTION
1	1	STAHLIN	DSW181610HPL	ENCLOSURE, FIBERGLASS, WINDOW DOOR, 18"x16"x10"
	1	STAHLIN	BP18P16	SUBPANEL, 18"x16"
2	1	CONTROL MICROSYSTEMS	P200-1A00-AA11	SCADAPACK LP, 5 ANALOG INPUTS, 2 ANALOG OUTPUTS, 8 I/O, INTEGRATED 900MHz RADIO
3	1	PHOENIX CONTACT	STEP-PS-100-240ACDC/	POWER SUPPLY, 120VAC-12VDC, 2.1 AMPS
4	2	WEIDMULLER	10143000000	FUSED TERMINAL BLOCK
	1	BUSSMAN	MDL-3	FUSE, 3 AMP
	1	BUSSMAN	MDL-5	FUSE, 5 AMP
5	1	SQUARE D	PK7GTA	GROUND BAR, 7 POSITION
6	35	WEIDMULLER	1020100000	TERMINAL BLOCK, WDU4, 22-10AWG, BEIGE
7	A/R	TY DUCT	NPB6 SERIES	WIRE DUCT, THIN FINGER, BLACK
8	1	OMEGA	PX181B-001G5V	PRESSURE TRANSDUCER, 0-1 PSI, 0-5VDC OUTPUT

BILL OF MATERIAL

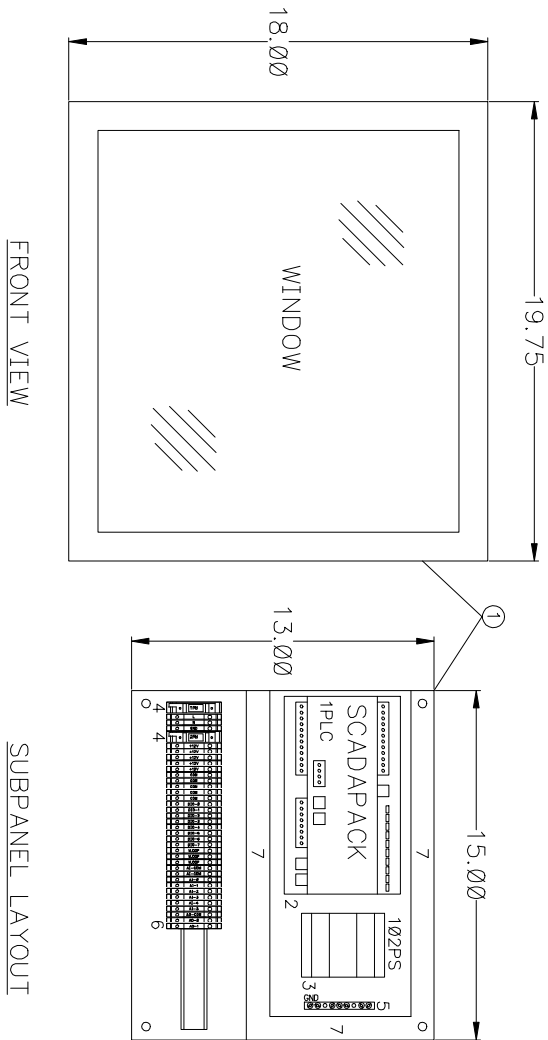

L	
N	
GND	
+12V	
+12V	
COM	
COM	
DIO-0	
DIO-1	
DIO-2	
DIO-3	
DIO-4	
DIO-5	
DIO-6	
DIO-7	
VLOOP	
VLOOP	
VLOOP	
AI-COM	
AI-COM	
AI-0	
AI-1	
AI-2	
AI-3	
AI-4	
AI-5	
AO-COM	
AO-0	
AO-1	

TERMINAL BLOCK LAYOUT



Control Systems, Inc.

3822 HIGHWAY 25
 MONTEVALLO, ALABAMA 35115
 (205) 679-4000 FAX: (205) 679-4274

1	RECORD DRAWING	1/9/08	
A	FOR CONSTRUCTION	10/1/07	
NO.	REVISION	DATE	

CUSTOMER:
 MISSISSIPPI STATE UNIVERSITY
 DEPT. OF COMPUTER SCIENCE
 AND ENGINEERING

PROJECT:
 SCADA DEMO
 GROUND WATER SYSTEM
 PANEL LAYOUT & BOM

DRAWN BY:	CHECKED BY:	DATE:
JHM	JWG	10/01/07
SCALE:	SHEET NO.	
NONE	1/2	
DRAWING NO.		
70104G01		